


Proposed Elevations


Daikin Product Ref:
Specification Manual
EPCE2002A, Page 43

Air Conditioning Installation

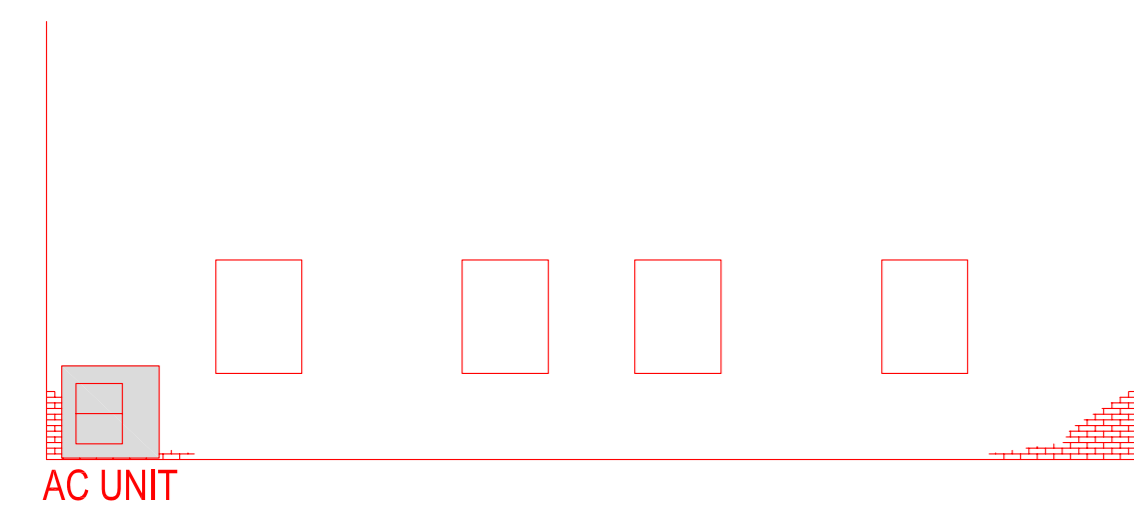


ELEVATION A

1 no R200 F7W15

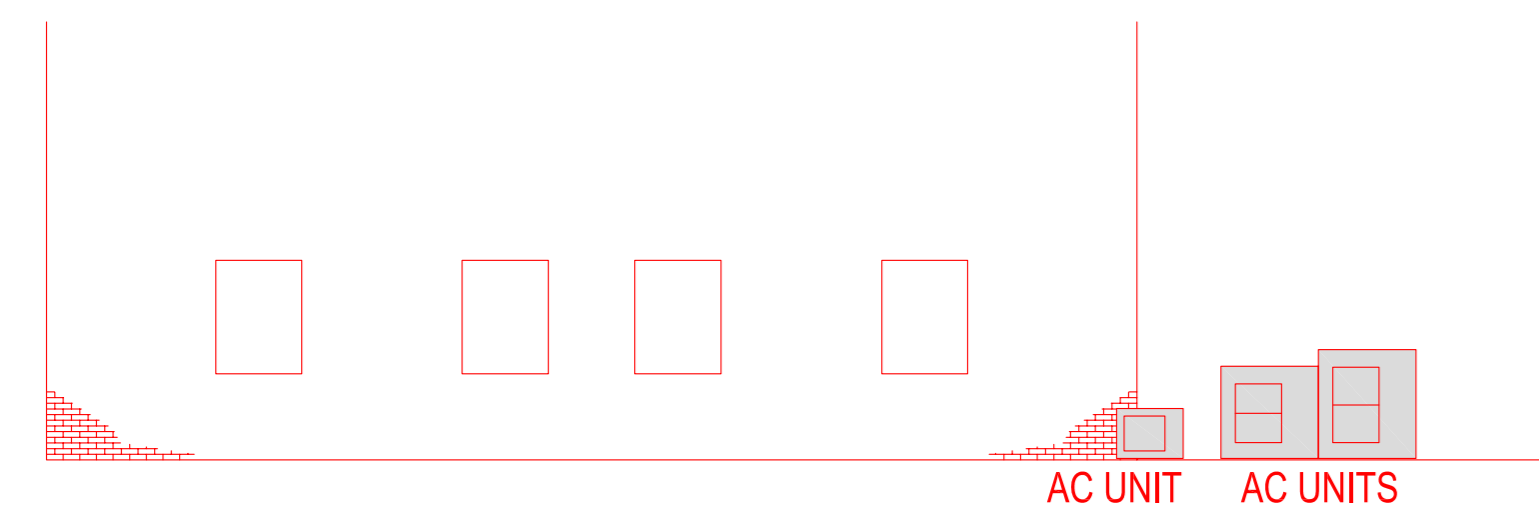


ELEVATION B

1 no R45 DC7V115
1 no R200 F7W15
1 no R250 F7W15

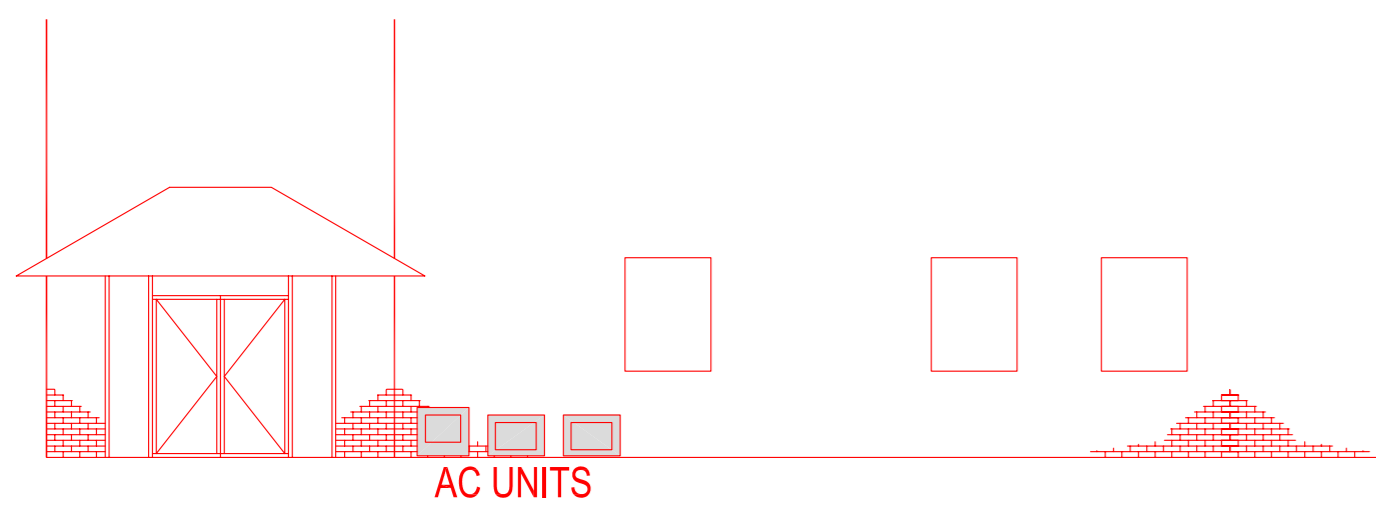


ELEVATION C

1 no R25 DC7V115
1 no R35 DC7V115
1 no R50 DC7V115

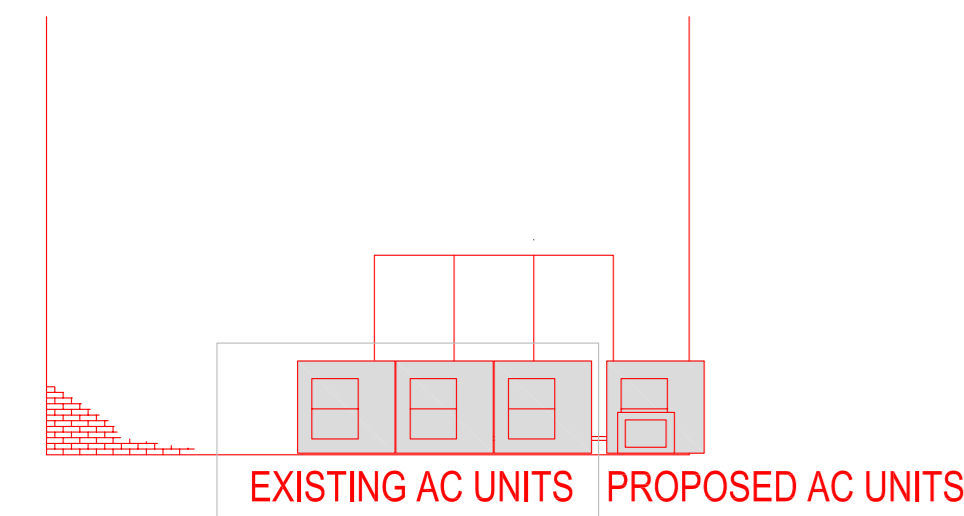


ELEVATION D

1 no R25 DC7V115
1 no R200 F7W15

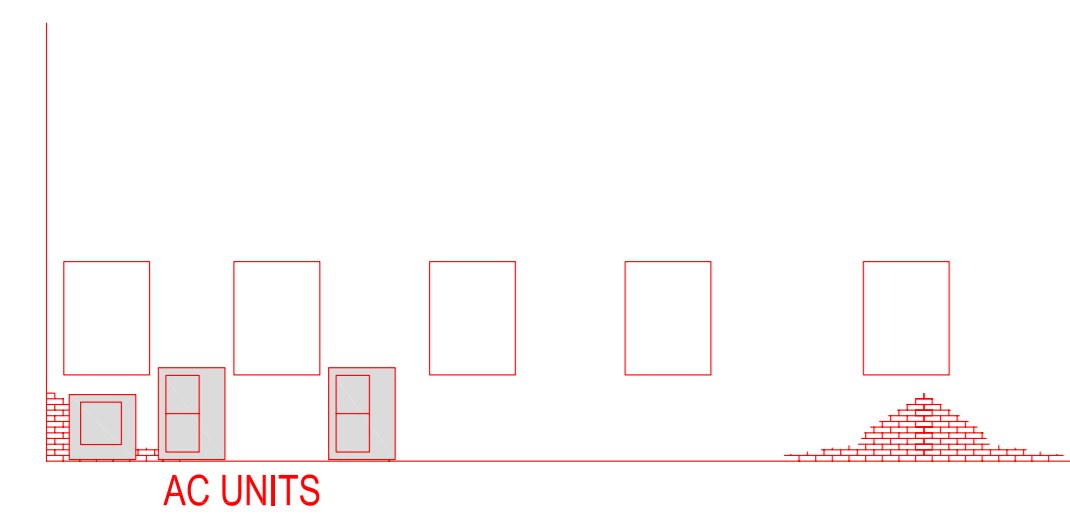

ELEVATION E


1 no R71 B7V15
1 no R100 B7V15
1 no R125 B7V15

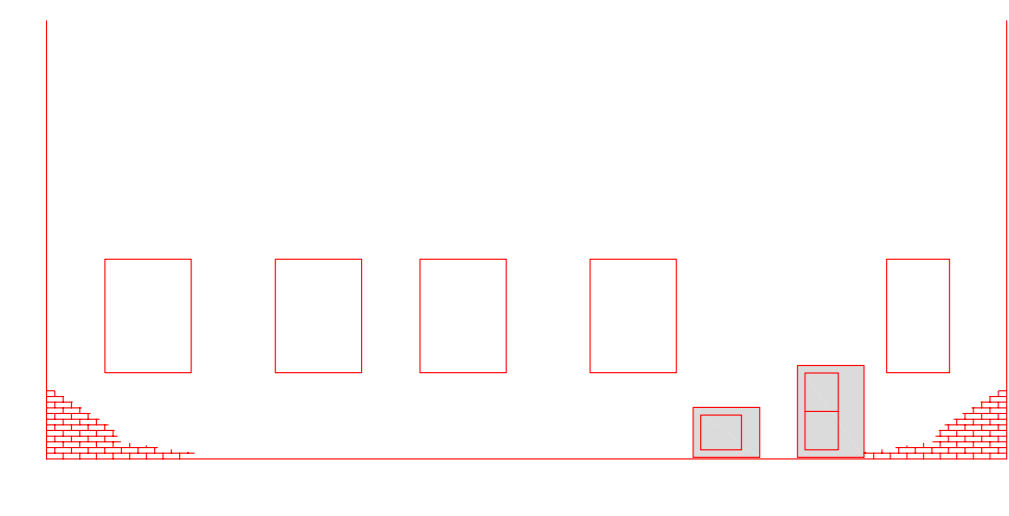

ELEVATION F

1 no R45 DC7V115
1 no R100 B7V15

SCALE 1:100

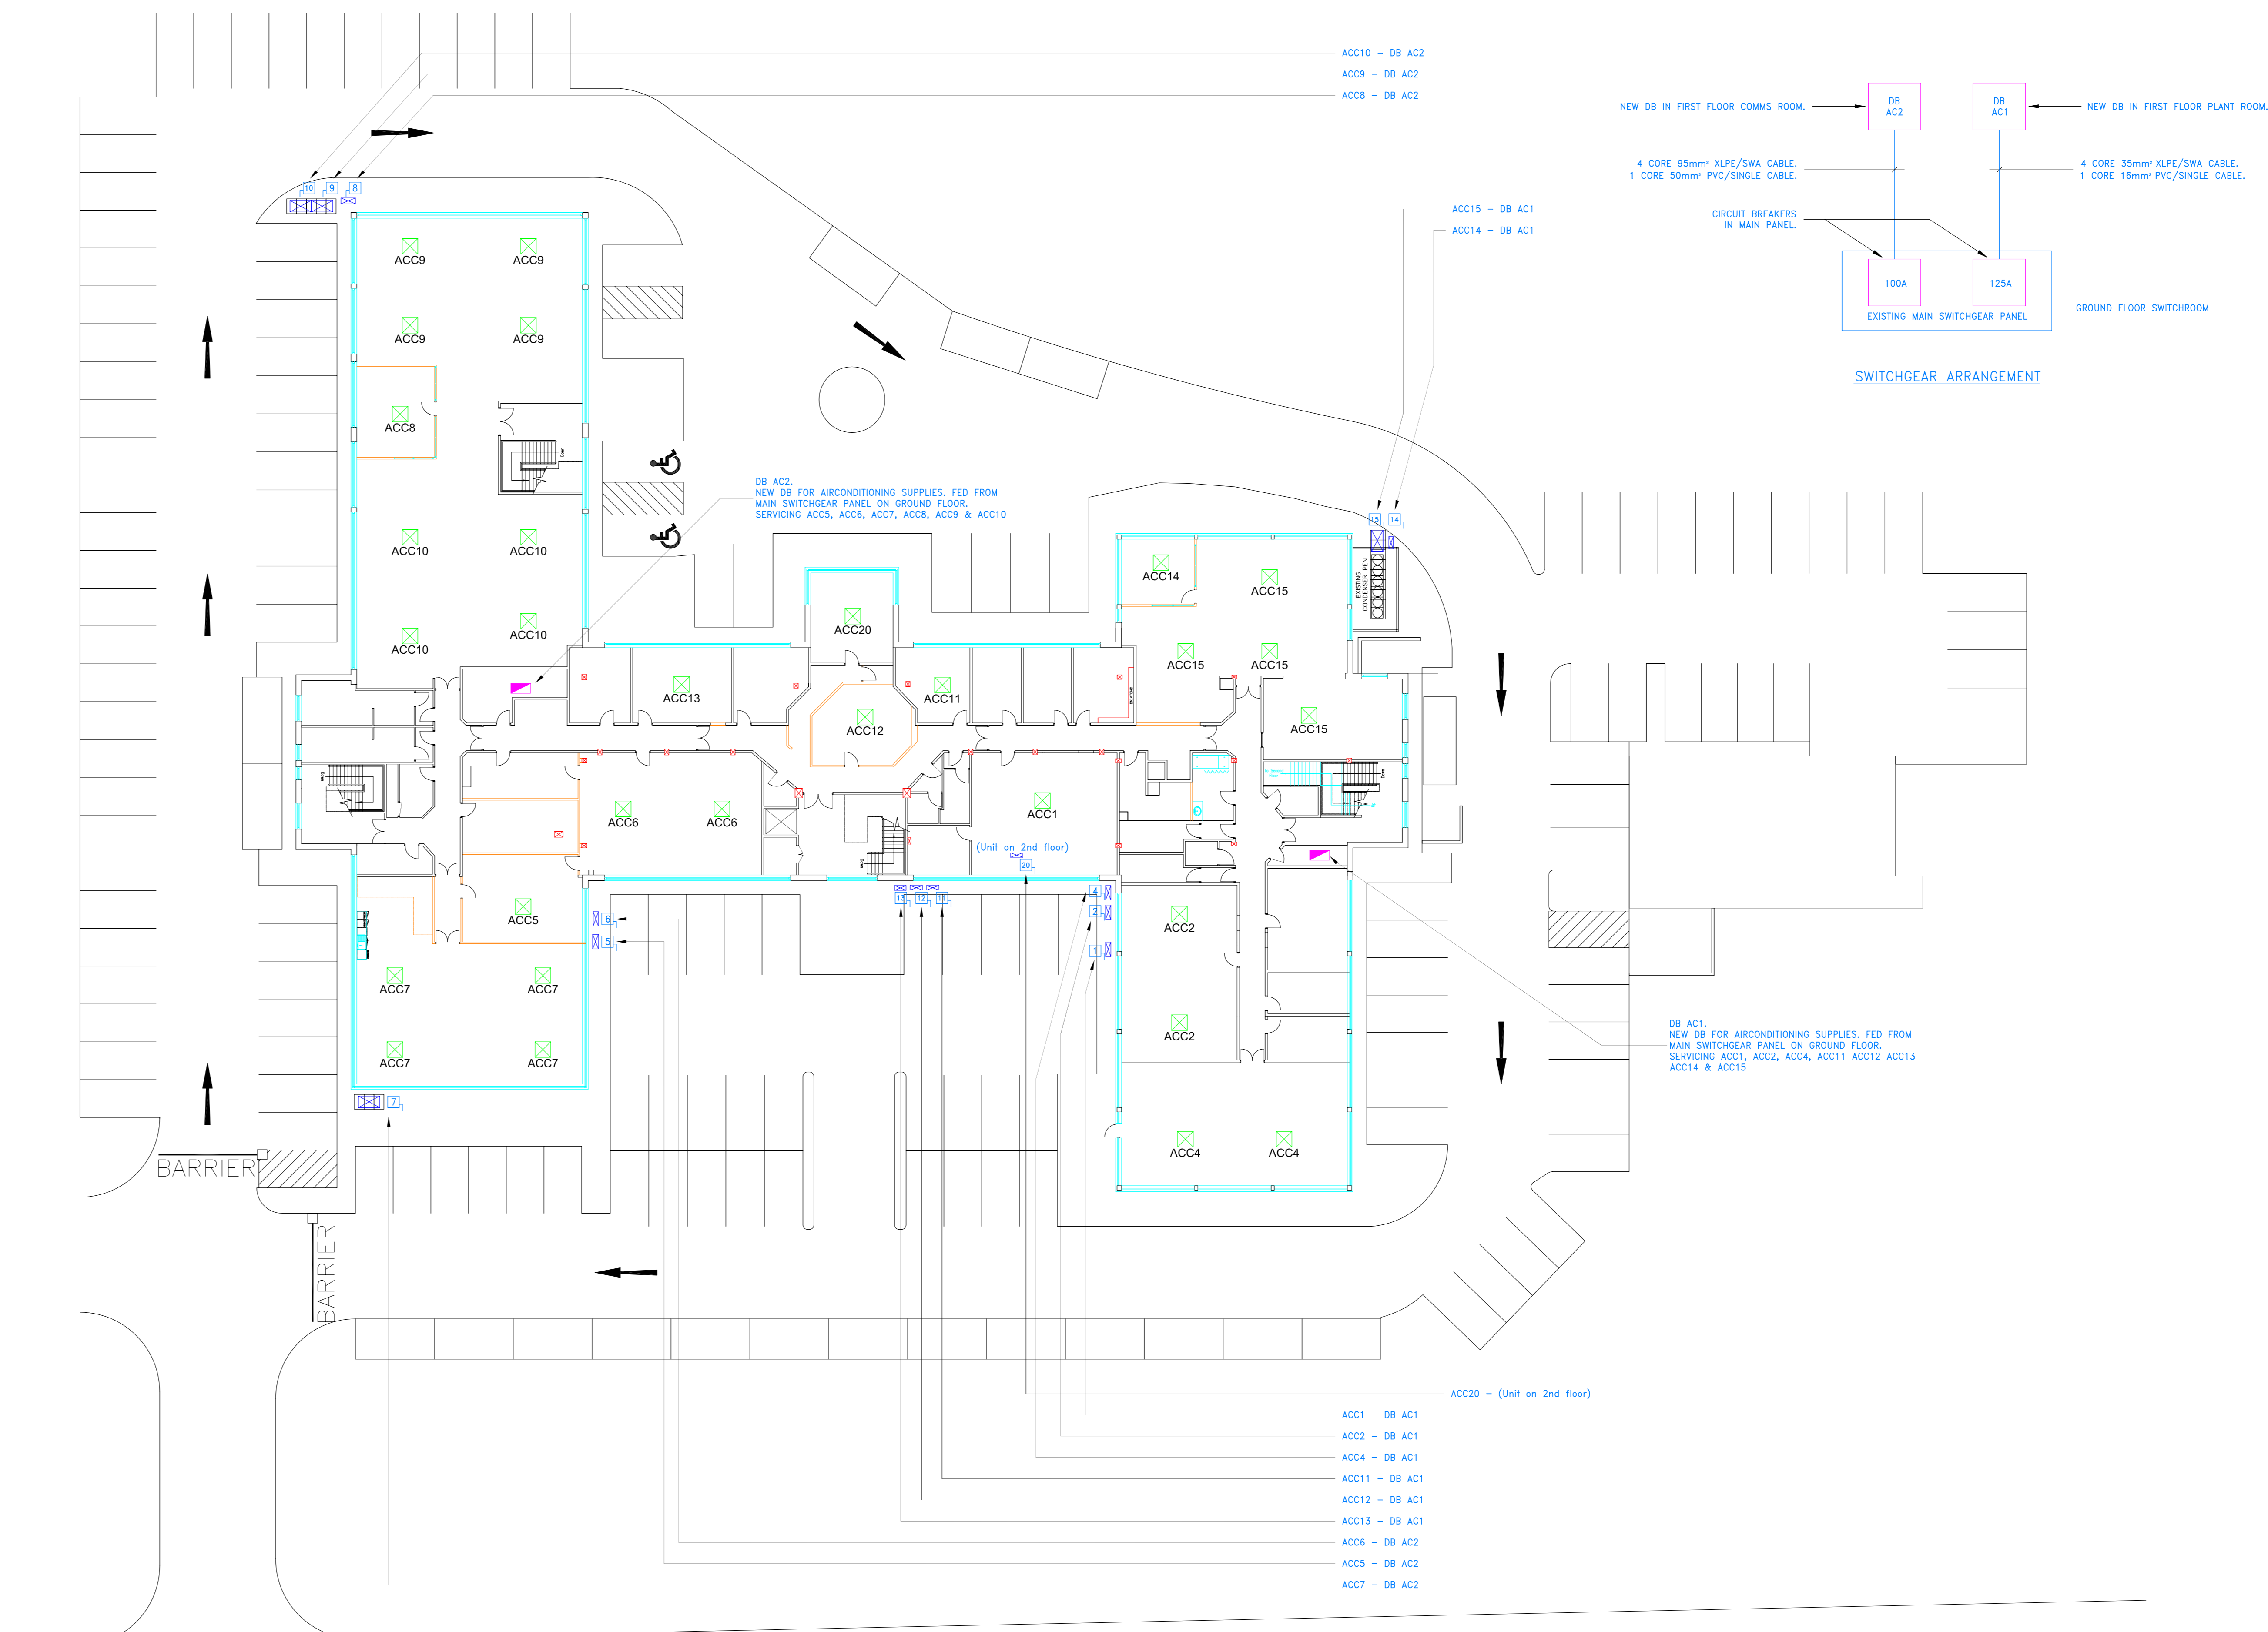

SCALE 1:200

No.	DESCRIPTION	DATE
11	Update A/C Plan Add Unit 20	
10	Update A/C As Installed	
09	Update A/C As Installed	
08	Update A/C External Units	
07	Update A/C External Units	
06	Add A/C External Units	
05	Update Site Plan	

REVISIONS
This drawing is the property of Level FM Ltd. Copyright is reserved by the client. It is to be used for the project only and not to be reproduced or used in any other way without the written consent of Level FM Ltd. All dimensions and details are to be checked on site before commencement of any work. This drawing is to be used in conjunction with the specifications, drawings, and all other supplementary information.

level fm
Workplace Solutions
Level Facilities Management Ltd
PO Box 20
Moorhouse
Leeds LS10 1JH
Tel: 01291 691104
Fax: 01291 691104
Email: cad@levelfm.co.uk

PROJECT:- Air Conditioning Installation
TITLE:- Proposed External Unit Locations Site Plan
SCALE: 1:200
DRAWING No. ---/---/sp- AO 11